PROTECTIVE MARKING UNCLASSIFIED
DRAWING REFERENCE No. SB/ALG/SRM/B2
DRAWING No. OSR--C07220 SHT 1 OF 1

DO NOT SCALE FROM THIS DRAWING

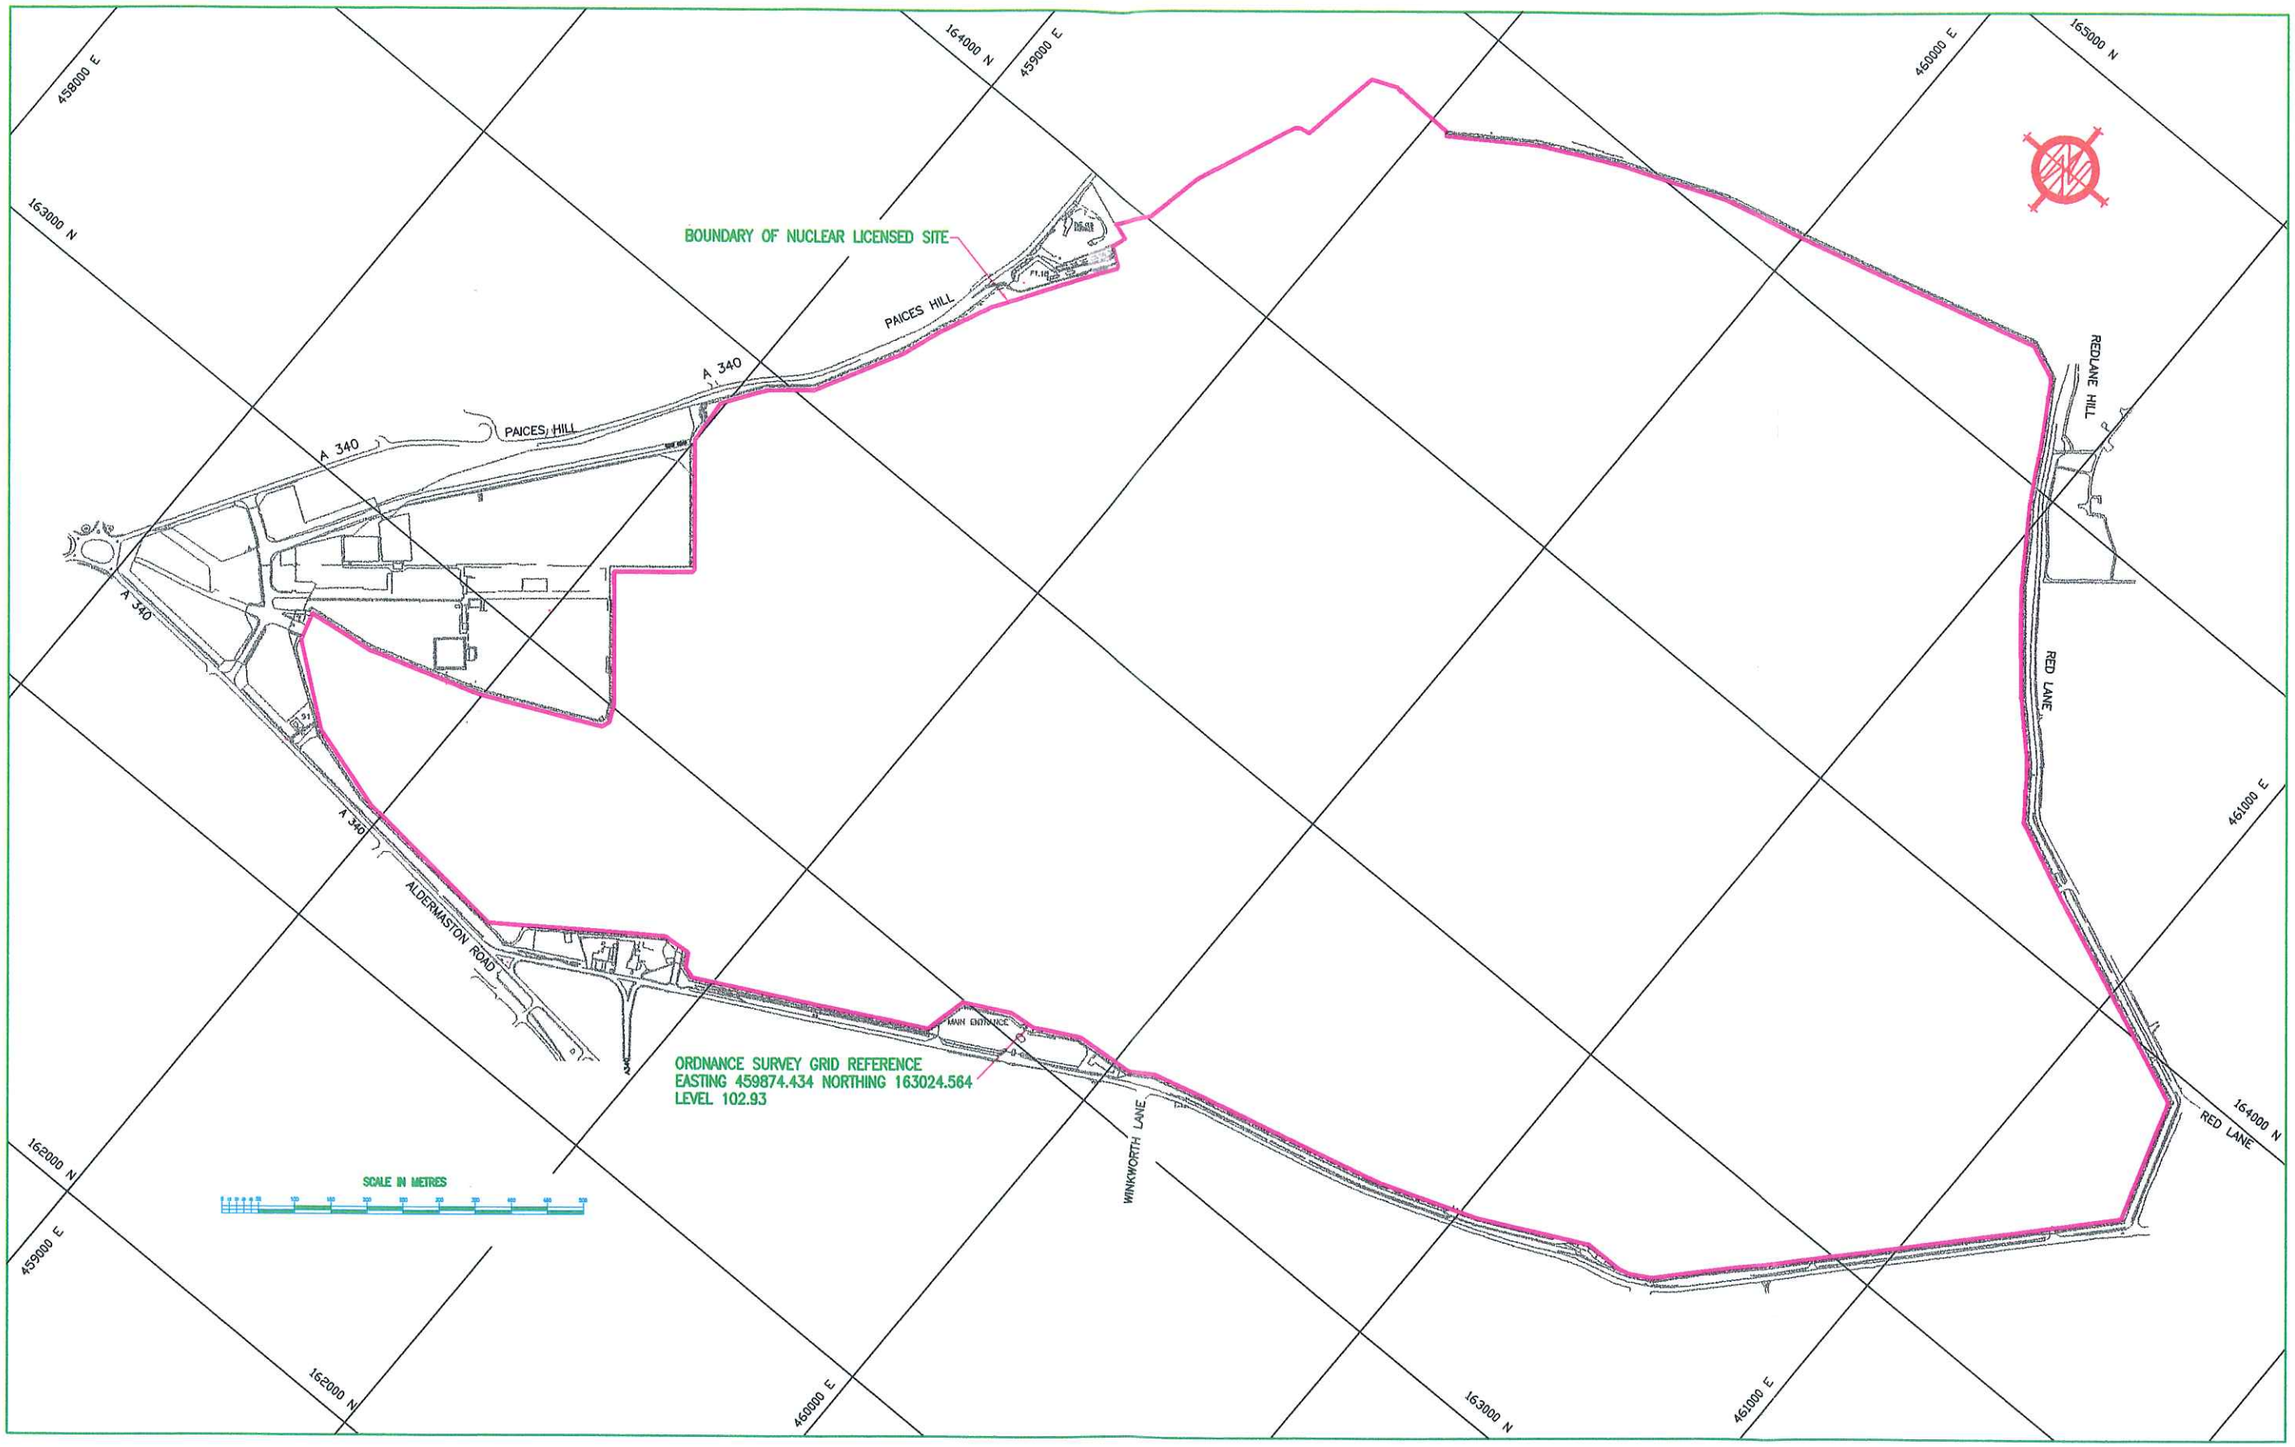

© Crown Copyright 2000

This Document is of United Kingdom origin and contains proprietary information, which is the property of the Secretary of State for Defence. It is furnished in confidence and may not be copied, used or disclosed in whole or in part without the prior written consent of the Director of Contracts (Strategic Systems Executive), Ministry of Defence, Procurement Executive, Rowan 1a, MoD Abbey Wood #166, PO Box 702, Bristol BS12 7DU, England.

RECORD DRAWING AS VERIFIED Date:- 24/01/00

CR/XOX/00/0008	B	24/01/00	
DR/SDP/97/0244	A	08/05/97	
CHANGE No / ACTION SHEET No	ISSUE	DATE	

MATERIAL
PROTECTIVE FINISH
SURFACE TEXTURE
TOLERANCES
SUB-CONTRACTOR
CAD REF. \GCPS\REC\A0\SR\C07 22000B01
ORIGINAL SCALE 1:3000
DIMS. IN M

TITLE: AWE(A) BOUNDARY NUCLEAR LICENSED SITE

ALDERMASTON, READING, BERKS, ENGLAND, RG7 4PR

SAFETY SYSTEM LEVEL: CRITICAL / ESSENTIAL / UNCLASSIFIED

PRINT CONTROL No. N
PROTECTIVE MARKING UK UNCLASSIFIED
DRAWING REFERENCE No. SB/ALG/SRM/B2
DRAWING No. OSR--C07220 SHT 1 OF 1

DRAWN	A. SU	
CHECKED	P. GENNISH	
CERTIFIED	C. PENNY	

DRAWING OFFICE REFERENCE WP 140001/00
DO.7 C21.1 AWE(A)

USED ON